

South Carolina Department of Health and Environmental Control  
Office of Ocean and Coastal Resource Management  
927 Shine Avenue  
Myrtle Beach, South Carolina 29577

**November 6, 2013**  
**Permit Application Public Notice**

***Thomas B. Barrineau, Jr., OCRM-13-305-S***

The Department has received an application for a permit for the alteration of a critical area. The application was submitted pursuant to the Coastal Zone Management Act (Act 123) of 1977 South Carolina General Assembly. The application in brief, is described as follows:

**LOCATION:** On and adjacent to Murrells Inlet Creek at 1944 Pompano Drive, Murrells Inlet, Georgetown County, South Carolina.  
TMS: 41-0130-020-13-00.


**WORK:** The work as proposed consists of seeking after-the-fact authorization for dock additions. The dock structure now consists of a 4' x 70' walkway, with handrails, leading to a covered 22' x 16' pierhead. Channelward of the pierhead, an ebbtide ramp will access a 422.5 square foot floating dock and 7' x 12' floating boatlift. Floodside of the walkway, a 6' x 12' deck and 12' x 12', four-pile boatlift is constructed. The work as described is to authorize constructed additions to a private, recreational dock.

This public notice is being distributed to all known interested persons and agencies to assist in developing facts on which a decision by the Department can be based. Comments concerning the proposed work must be submitted in writing, setting forth sufficient detail to furnish a clear understanding of the reasons for support or opposition.

Comments regarding this application must be received by the Department on or before **November 21, 2013**. For more information, please contact:  
**Chris Stout at 843-238-4528 or via email at [stoutcm@dhec.sc.gov](mailto:stoutcm@dhec.sc.gov).**




**NOTE:** Plans depicting the proposed work are available and will be provided upon receipt of a written request or may be viewed on the Department website at **[www.scdhec.gov/environment/ocrm/public\\_notice.htm](http://www.scdhec.gov/environment/ocrm/public_notice.htm)**.

## MURRELLS INLET CREEK

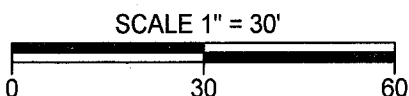

JAMES S. RUSSELL


# SOUTH PROFILE

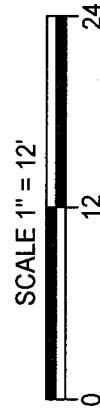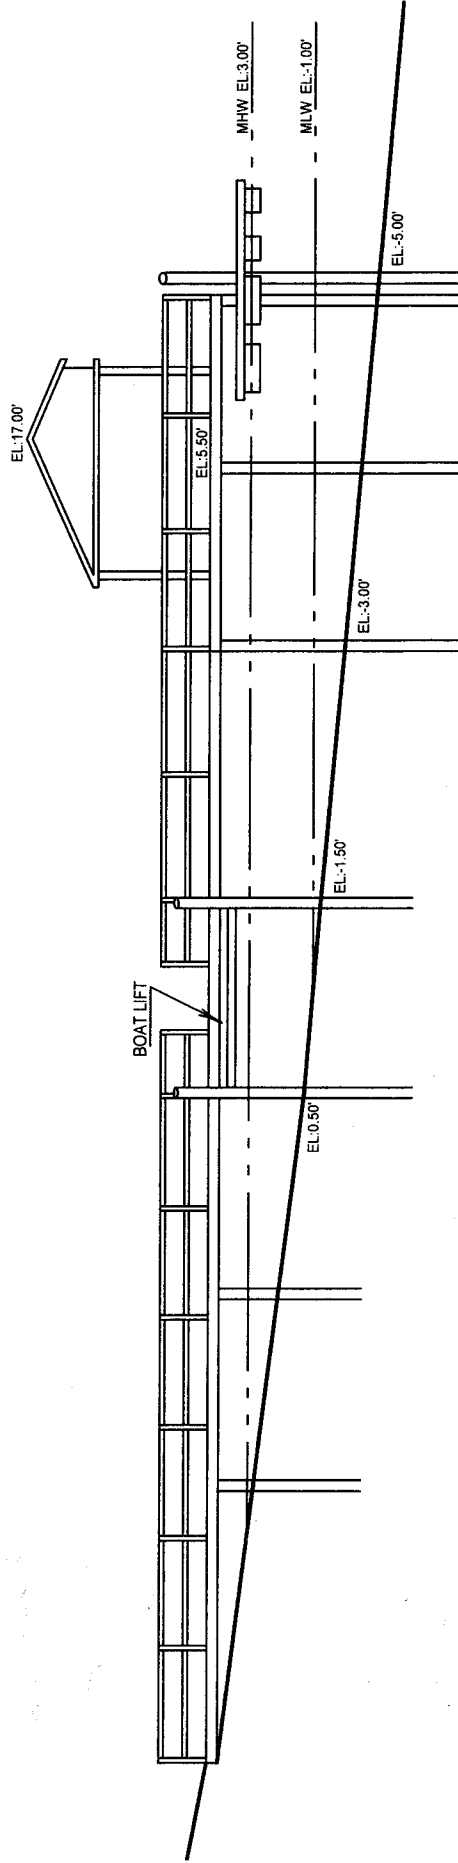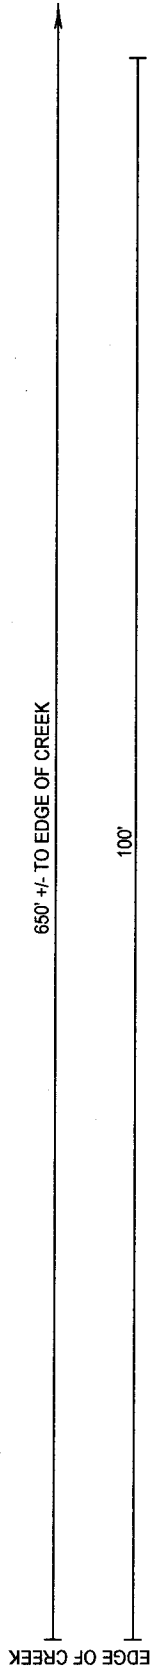

*Handwritten signature*

<b>APPLICANT:</b> THOMAS S. BARRINEAU <b>ACTIVITY:</b> 4'x70' BOARDWALK, 72 SQ. FT. GANGWAY, 144 SQ. FT. BOAT LIFT, 352 SQ. FT. FIXED DOCK, RAMP, 422.5 SQ. FT. FLOATING DOCK, AND A 84 SQ. FT. FLOATING BOAT STORAGE UNIT (F.B.S.U.) P/N # <b>OCRN-13-305-S</b>	<b>LOCATION:</b> 1944 POMPAÑO DRIVE <b>COUNTY:</b> GEORGETOWN <b>DATE:</b> SEPTEMBER 30, 2013	<b>ADJACENT PROPERTY OWNERS:</b> PHILLIP L. ELVIS JAMES S. RUSSELL
--	--	--

# AS-BUILT

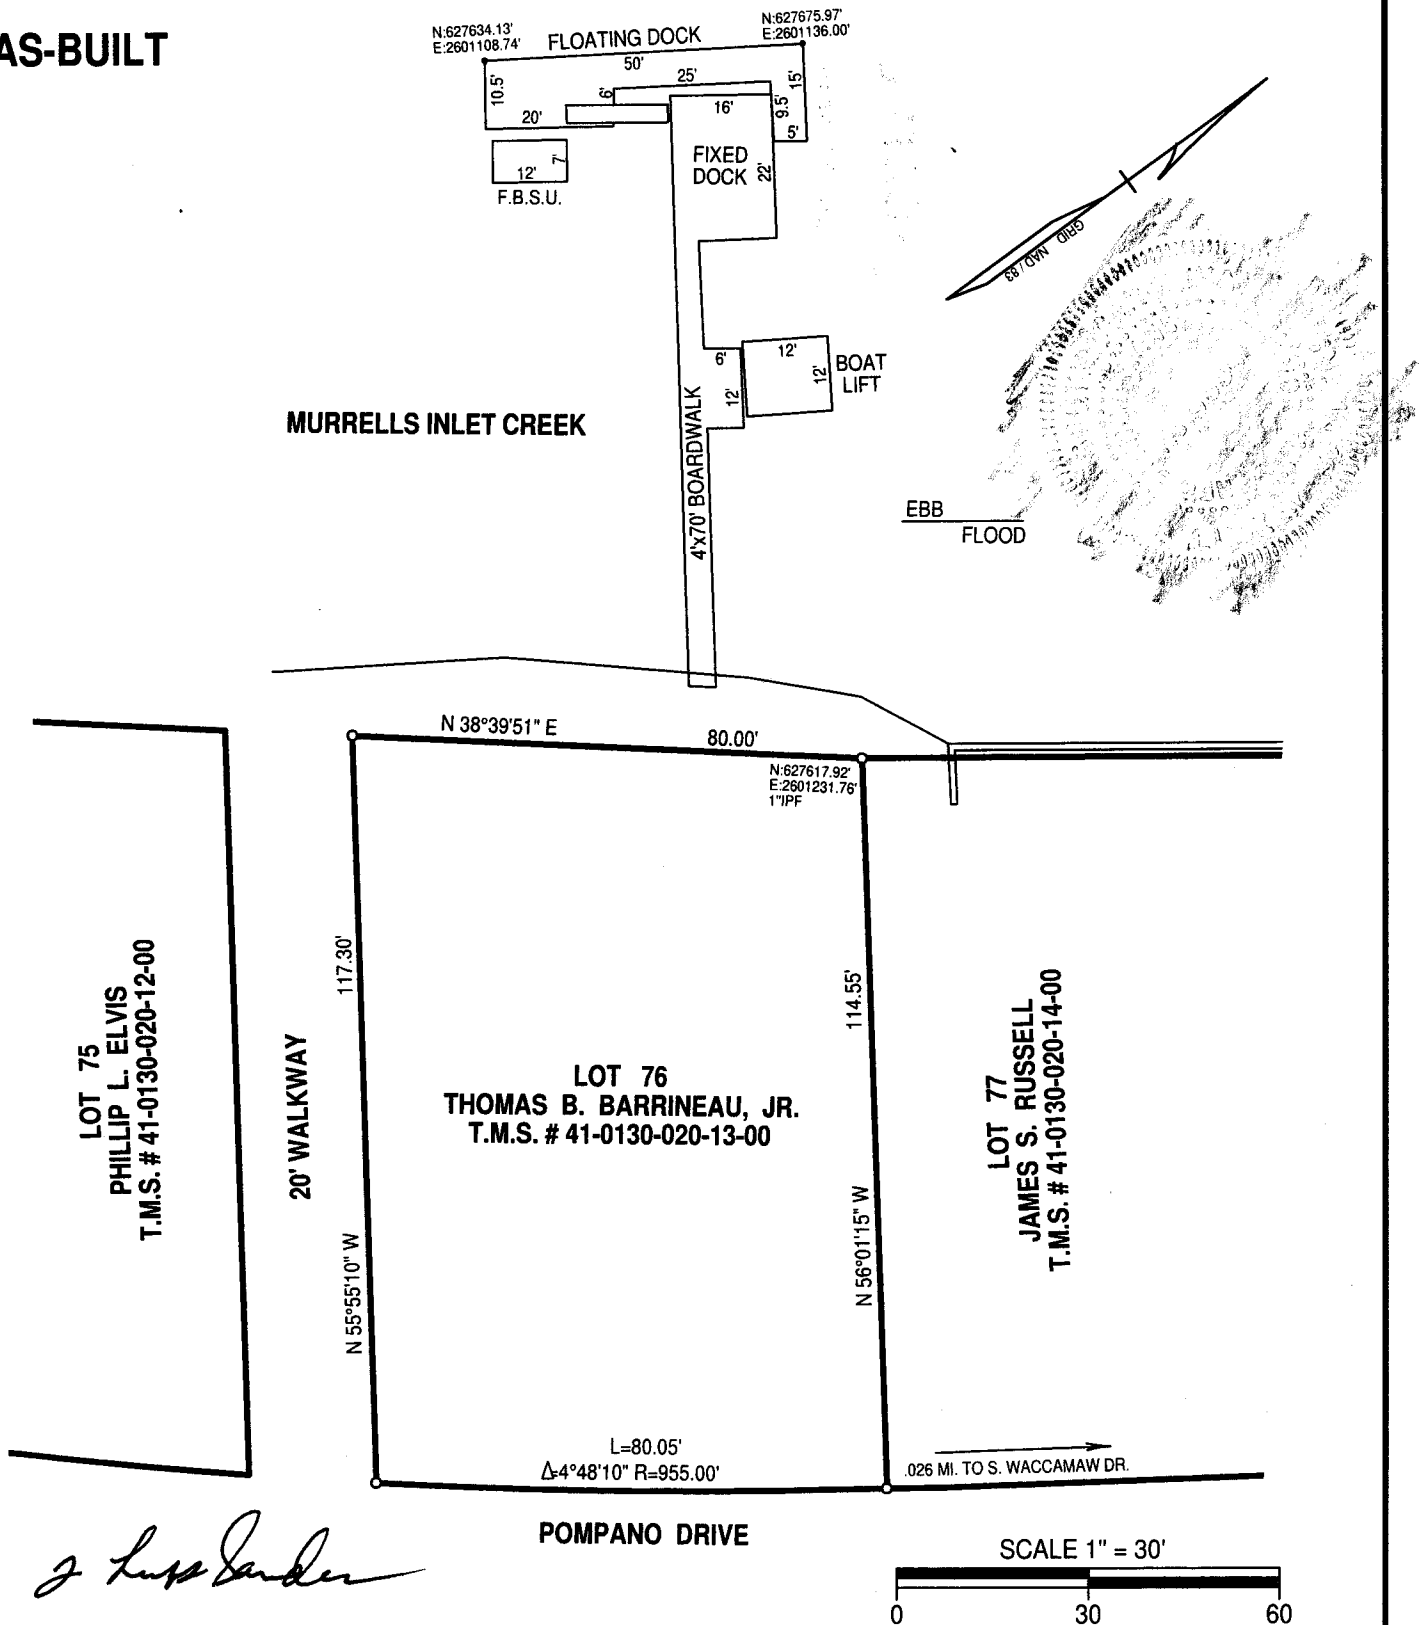



Map data ©2013 Google 200 m

1944 Pompano Dr.  
Thomas Barrineau  
OCRM-13-305-S